


B. Location of Emergency Power Supply System No.1 of T2 Building Proposed SI Locations for Expansion of T2 Building

B.1 Location of Emergency Power Supply System No.1 of T2 Building (Overview)

B.2 Location of Emergency Power Supply System No.1 of T2 Building (Zoom-in View of Northern Section of T2 Building)

Appendix B.1

Location of Emergency Power Supply System No.1 of T2 Building (Overview)

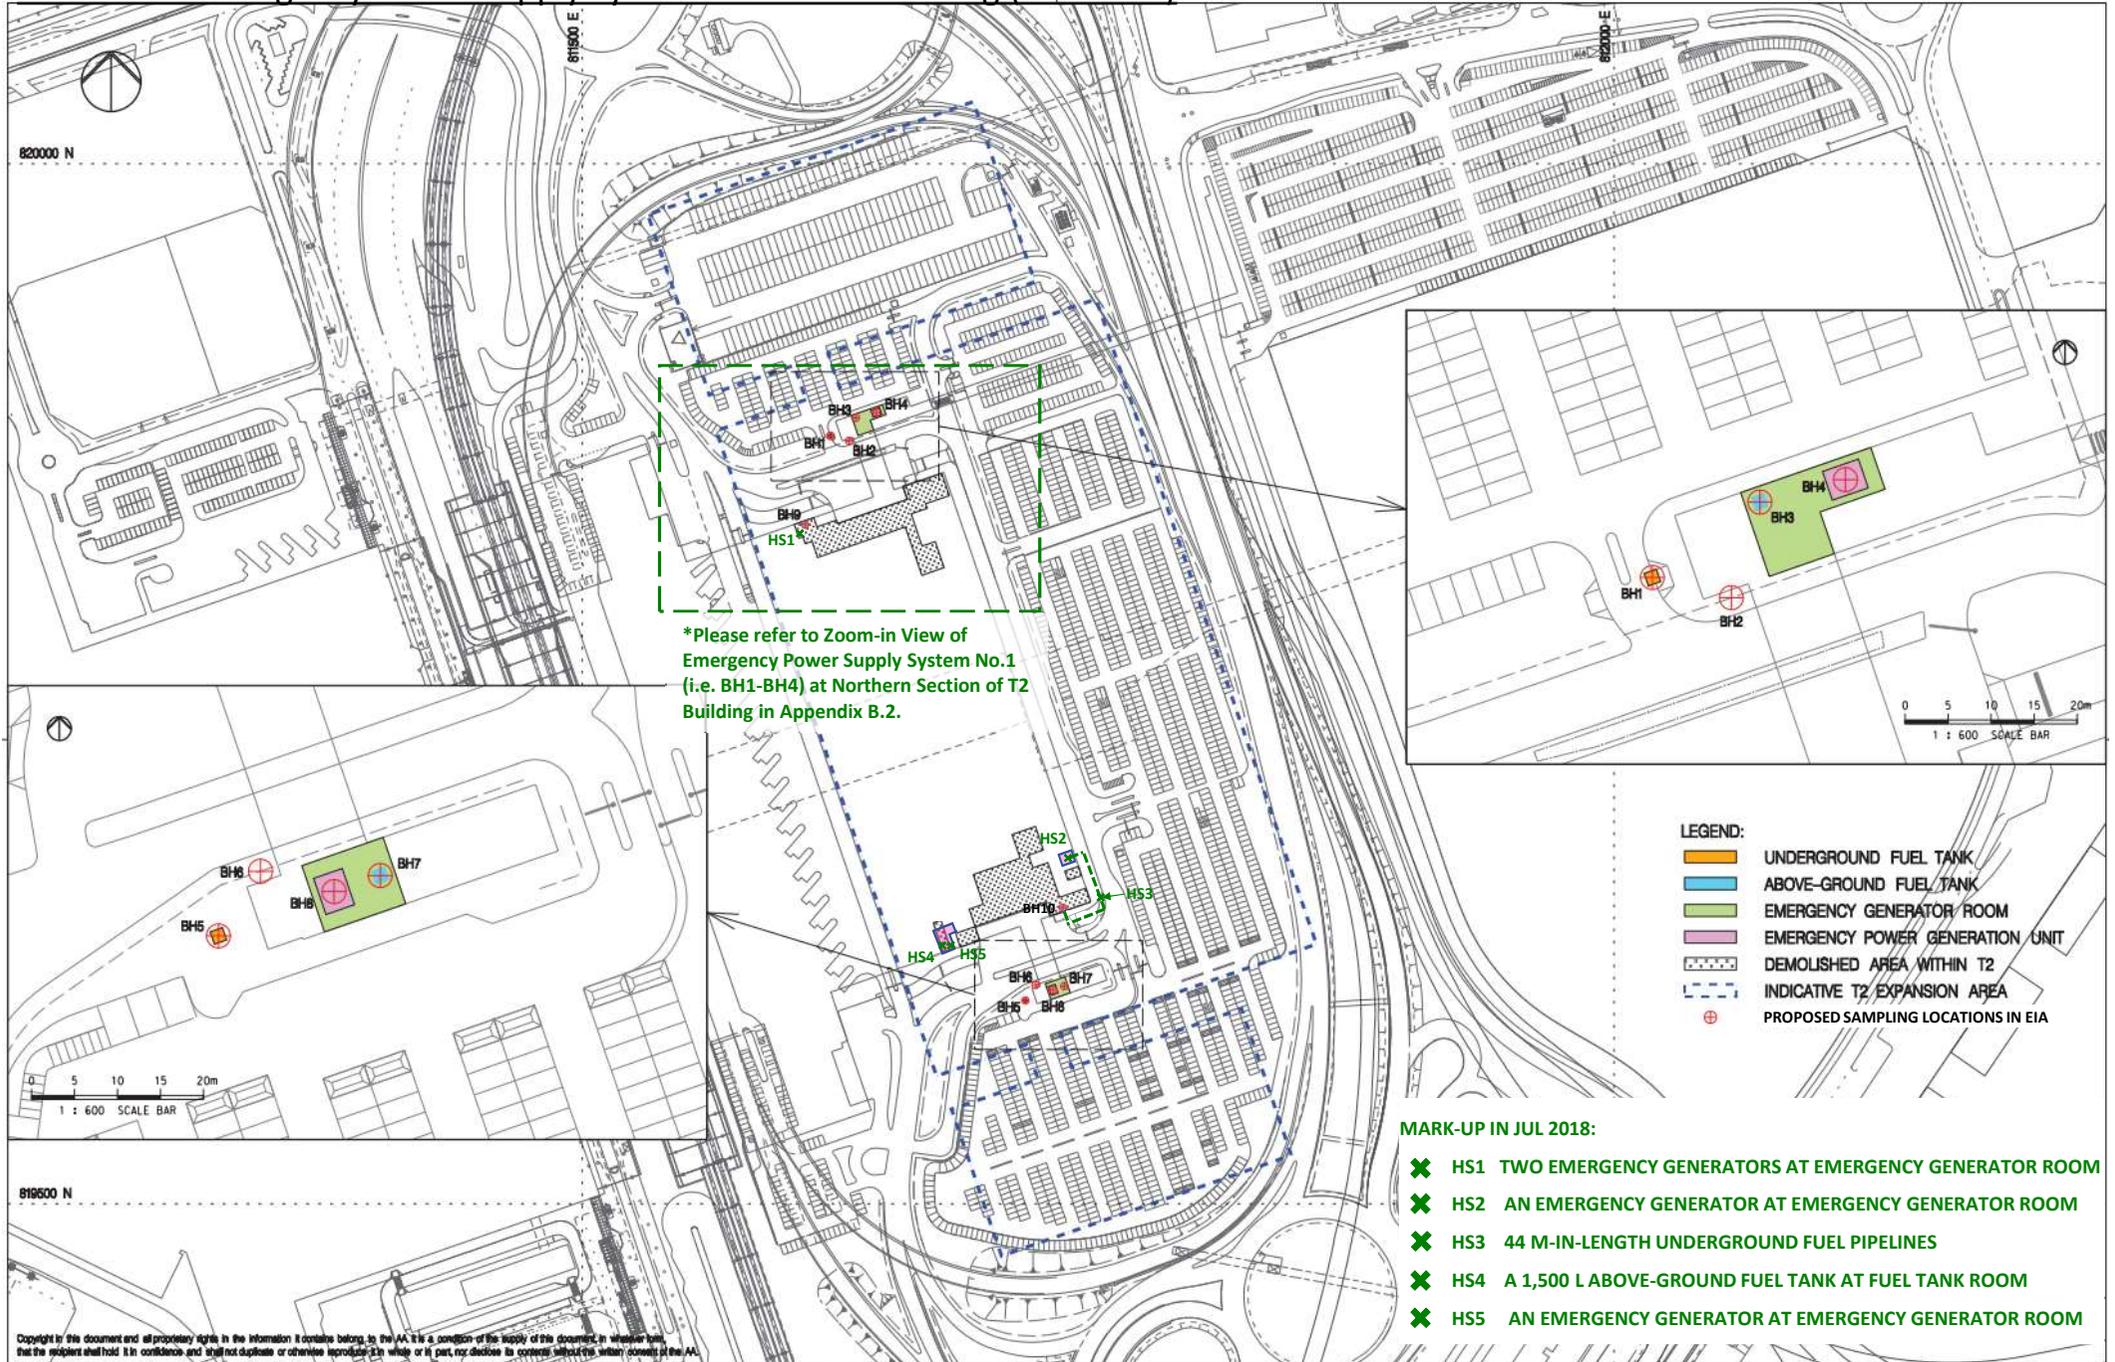

Copyright in this document and all proprietary rights in the information it contains belong to the AA. It is a condition of the supply of this document in whatever form, that the recipient shall hold it in confidence and shall not duplicate or otherwise reproduce it in whole or in part, nor disclose its contents without the written consent of the AA.

Rev.	Date	Description	Checked
A	23OCT13	FIRST ISSUE	EC
B	21NOV13	GENERAL REVISION	AM
C	17DEC13	GENERAL REVISION	AM

Title: PROPOSED SAMPLING LOCATIONS FOR EXPANSION OF T2 BUILDING

Consultant's Signatures for Approval		Date	EXPANSION OF HONG KONG INTERNATIONAL AIRPORT INTO A THREE-RUNWAY SYSTEM
Design	AM	23OCT13	
Checkers	AM	23OCT13	
Design Supervisor	EC	21MAR14	
Authorised Representative	AFK	21MAR14	


Drawing No. MCL / P132 / EIA / 11-014

Scale at A3: 1 : 2500

Rev. C

Appendix B.2

Location of Emergency Power Supply System No.1 of T2 Building (Zoom-in View of Northern Section of T2 Building)

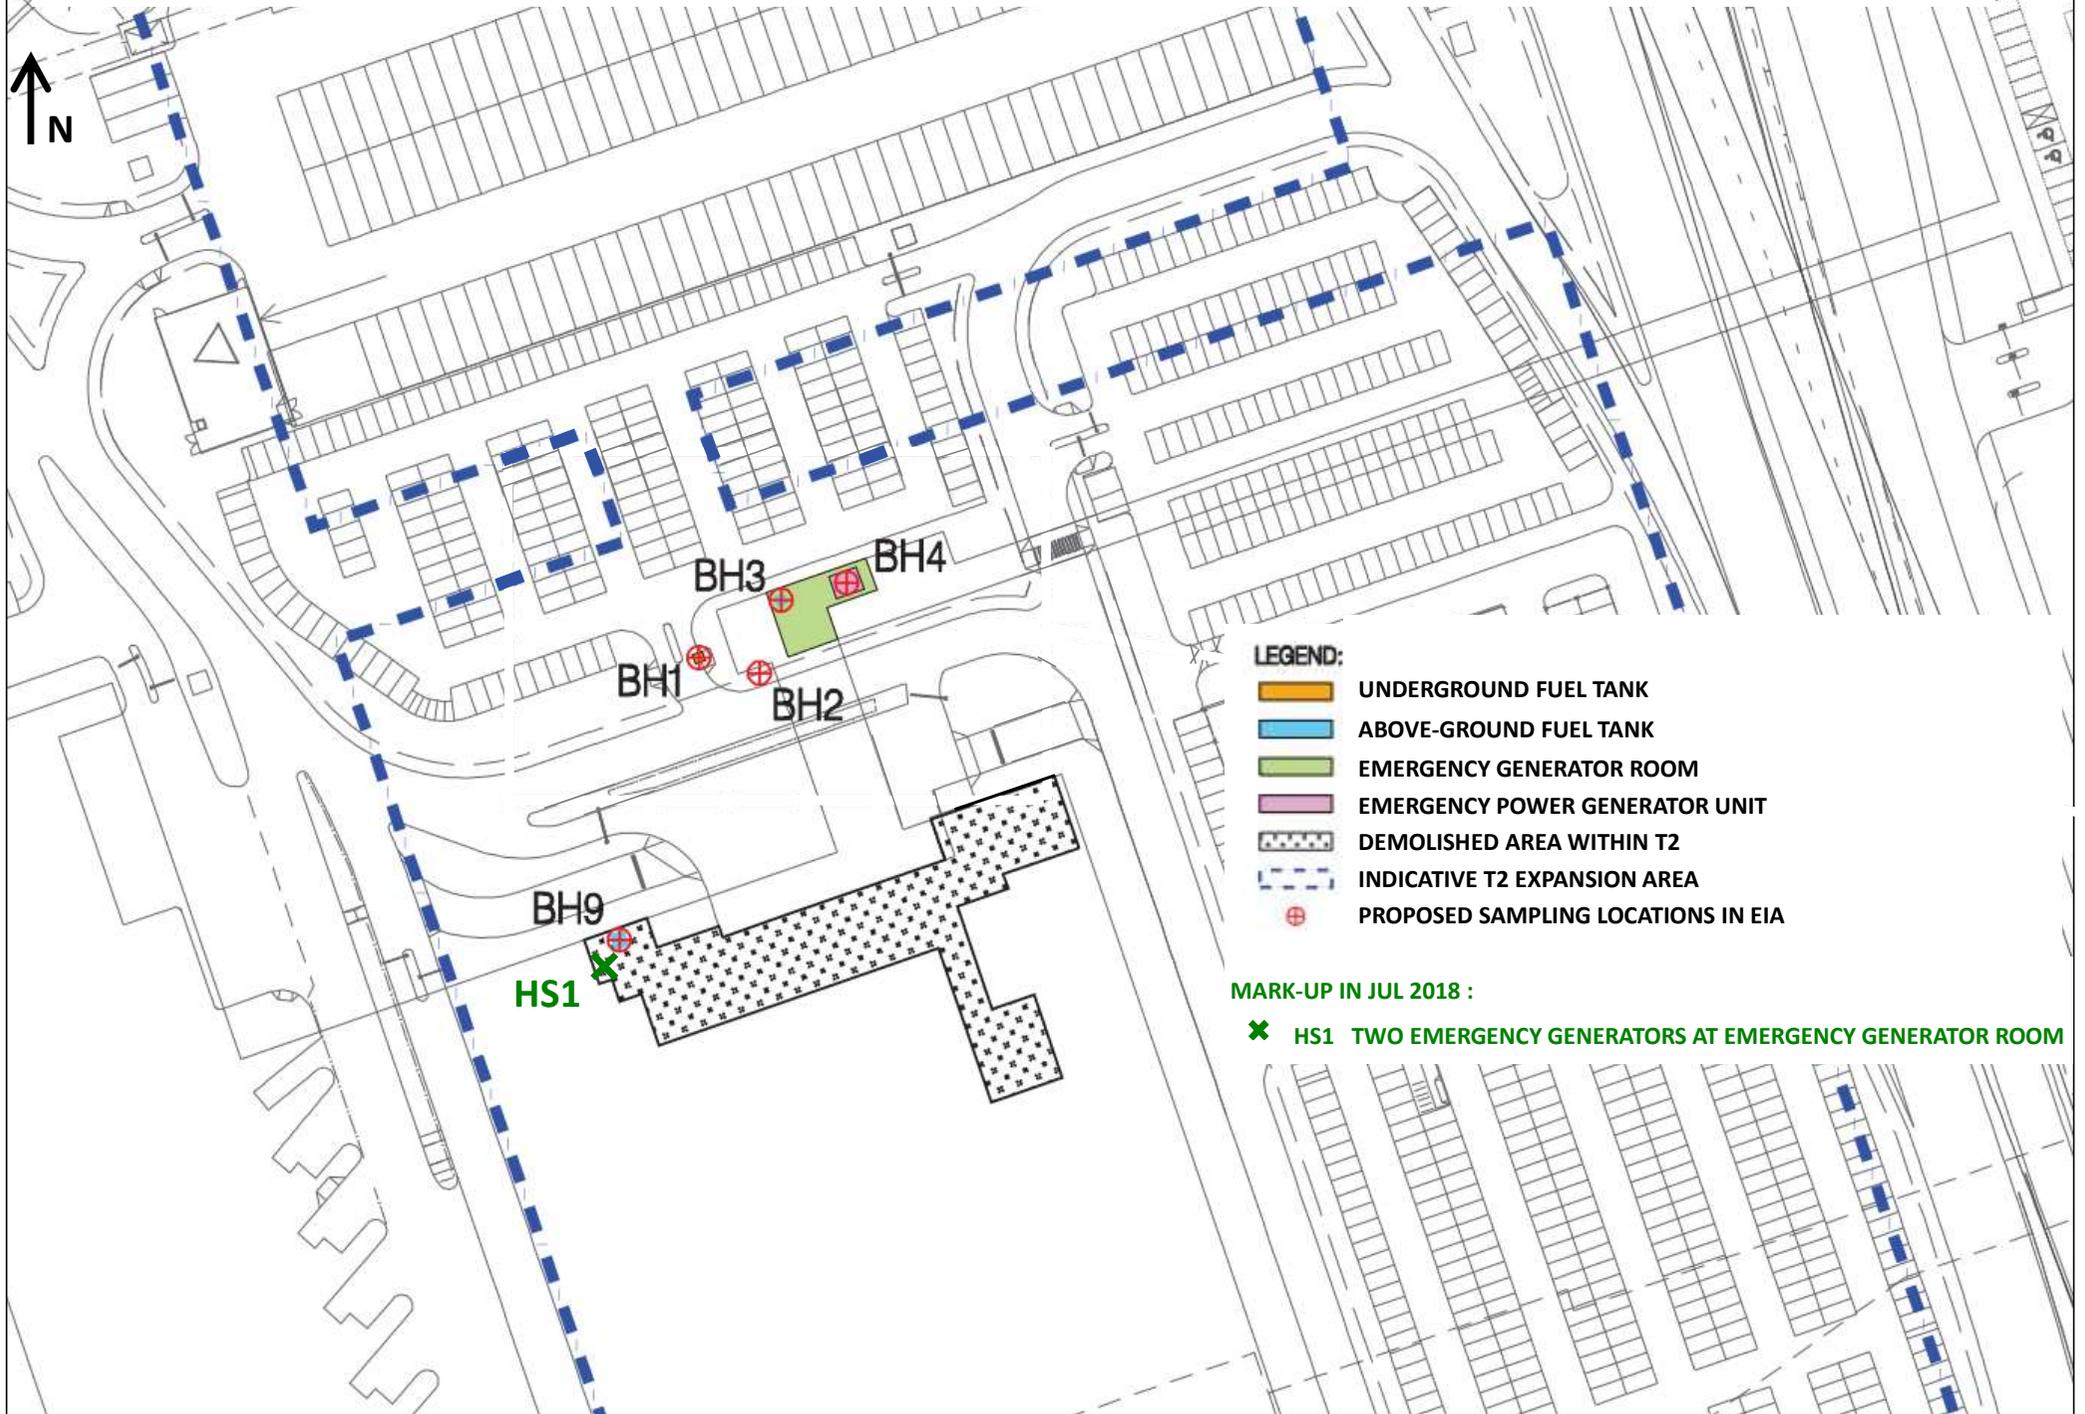

LEGEND:

-  UNDERGROUND FUEL TANK
-  ABOVE-GROUND FUEL TANK
-  EMERGENCY GENERATOR ROOM
-  EMERGENCY POWER GENERATOR UNIT
-  DEMOLISHED AREA WITHIN T2
-  INDICATIVE T2 EXPANSION AREA
-  PROPOSED SAMPLING LOCATIONS IN EIA

MARK-UP IN JUL 2018 :

X HS1 TWO EMERGENCY GENERATORS AT EMERGENCY GENERATOR ROOM